

Apr. 22, 1981 Renewed. rph

580-111
Code

DATE May 1, 1981

LOCATION HARRISON

Township

*SEE 96255

S $\frac{1}{2}$ NW $\frac{1}{4}$ NO. $\frac{1}{4}$; Sec. 8; T 4 S; R 9 E

1150 5m. TH HILL RD

(circle one)		
Existing Home	New Home	Mobile Home
City Water	Cistern	Well
Subdivision <u>3 Acres</u>	Lot	
Basement w-plumbing fixtures	Yes	No

HARRISON COUNTY HEALTH DEPT.
Rural Route 6, Box 80
Corydon, Indiana
47112

APPLICATION FOR SITE SURVEY AND SEWAGE DISPOSAL PERMIT

Directions To Property South of Road approx. 3/4 mile on left.

And Lot Size: _____

OWNER'S NAME AND MAILING ADDRESS _____ INSTALLER'S NAME AND ADDRESS _____

Edward Runyon
622 N. CAPITAL AVE. Corydon

Lornie Snyder
Corydon

TELEPHONE 738-3317 TELEPHONE _____

NO. OF BEDROOMS 11 NO. OF BATHS 2 1/2 AUTOMATIC WASHER YES NO _____

* HOME MUST BE STAKED OFF BEFORE SURVEY IS CONDUCTED
* DO NOT WRITE BELOW THIS LINE *

SOIL TYPE: BLC₃

Estimated Depth To Bedrock or Water Table: _____

SPECIAL Recommendations: Follow contours. Suggest running laterals
North & Northeast with slope. Do NOT locate driveway over
lateral field

SEPTIC TANK CAPACITY 1000 gal (DRAINFIELD: TRENCH DEPTH 30" TRENCH WIDTH 24"

TOTAL LENGTH OF TILELINE 660 feet USING RIVER GRAVEL (No Crushed Stone)


APPLICATION FOR PERMIT APPROVED NOT APPROVED _____

DATE: May 24, 1981 Fee Received: _____ SANITARIAN Richard Schwardt

FINAL INSPECTION: Approved DATE: July 14, 1981 R. Schwardt
Sanitarian

NOTE:
THE SEWAGE DISPOSAL PERMIT MUST BE APPROVED BEFORE CONSTRUCTION IS STARTED
INSPECTION MUST BE MADE BEFORE THE LATERAL LINES ARE COVERED.
Call for inspection either the day before or between 8:00 and 9:00 in mornings, 738-3237.
The maximum length of any one trench is 100 feet.
Six (6) inches of gravel under lateral lines and two (2) inches above pipe.
Must be installed 50 feet or more from water supply lines.
Ten (10) feet or more from property lines.
Distances between trenches — Six (6) feet.
On the back draw a plot diagram showing the size and shape of the lot, location of utility buildings, wells, roads, and/or streams within 100 feet of the disposal system, the location of the septic tank, and the location of the drainage field. Approximate distances must be shown from the disposal system to any proposed or existing water lines, wells, streams, and the lot lines.
If construction is not started within a period of one year, this permit is void.

WARNING: THIS PERMIT IN NO WAY GUARANTEES THE OPERATION OF THIS PRIVATE SEWAGE DISPOSAL SYSTEM. IT ONLY AFFIRMS THAT THE SYSTEM WAS INSTALLED TO PRESCRIBED STANDARDS.

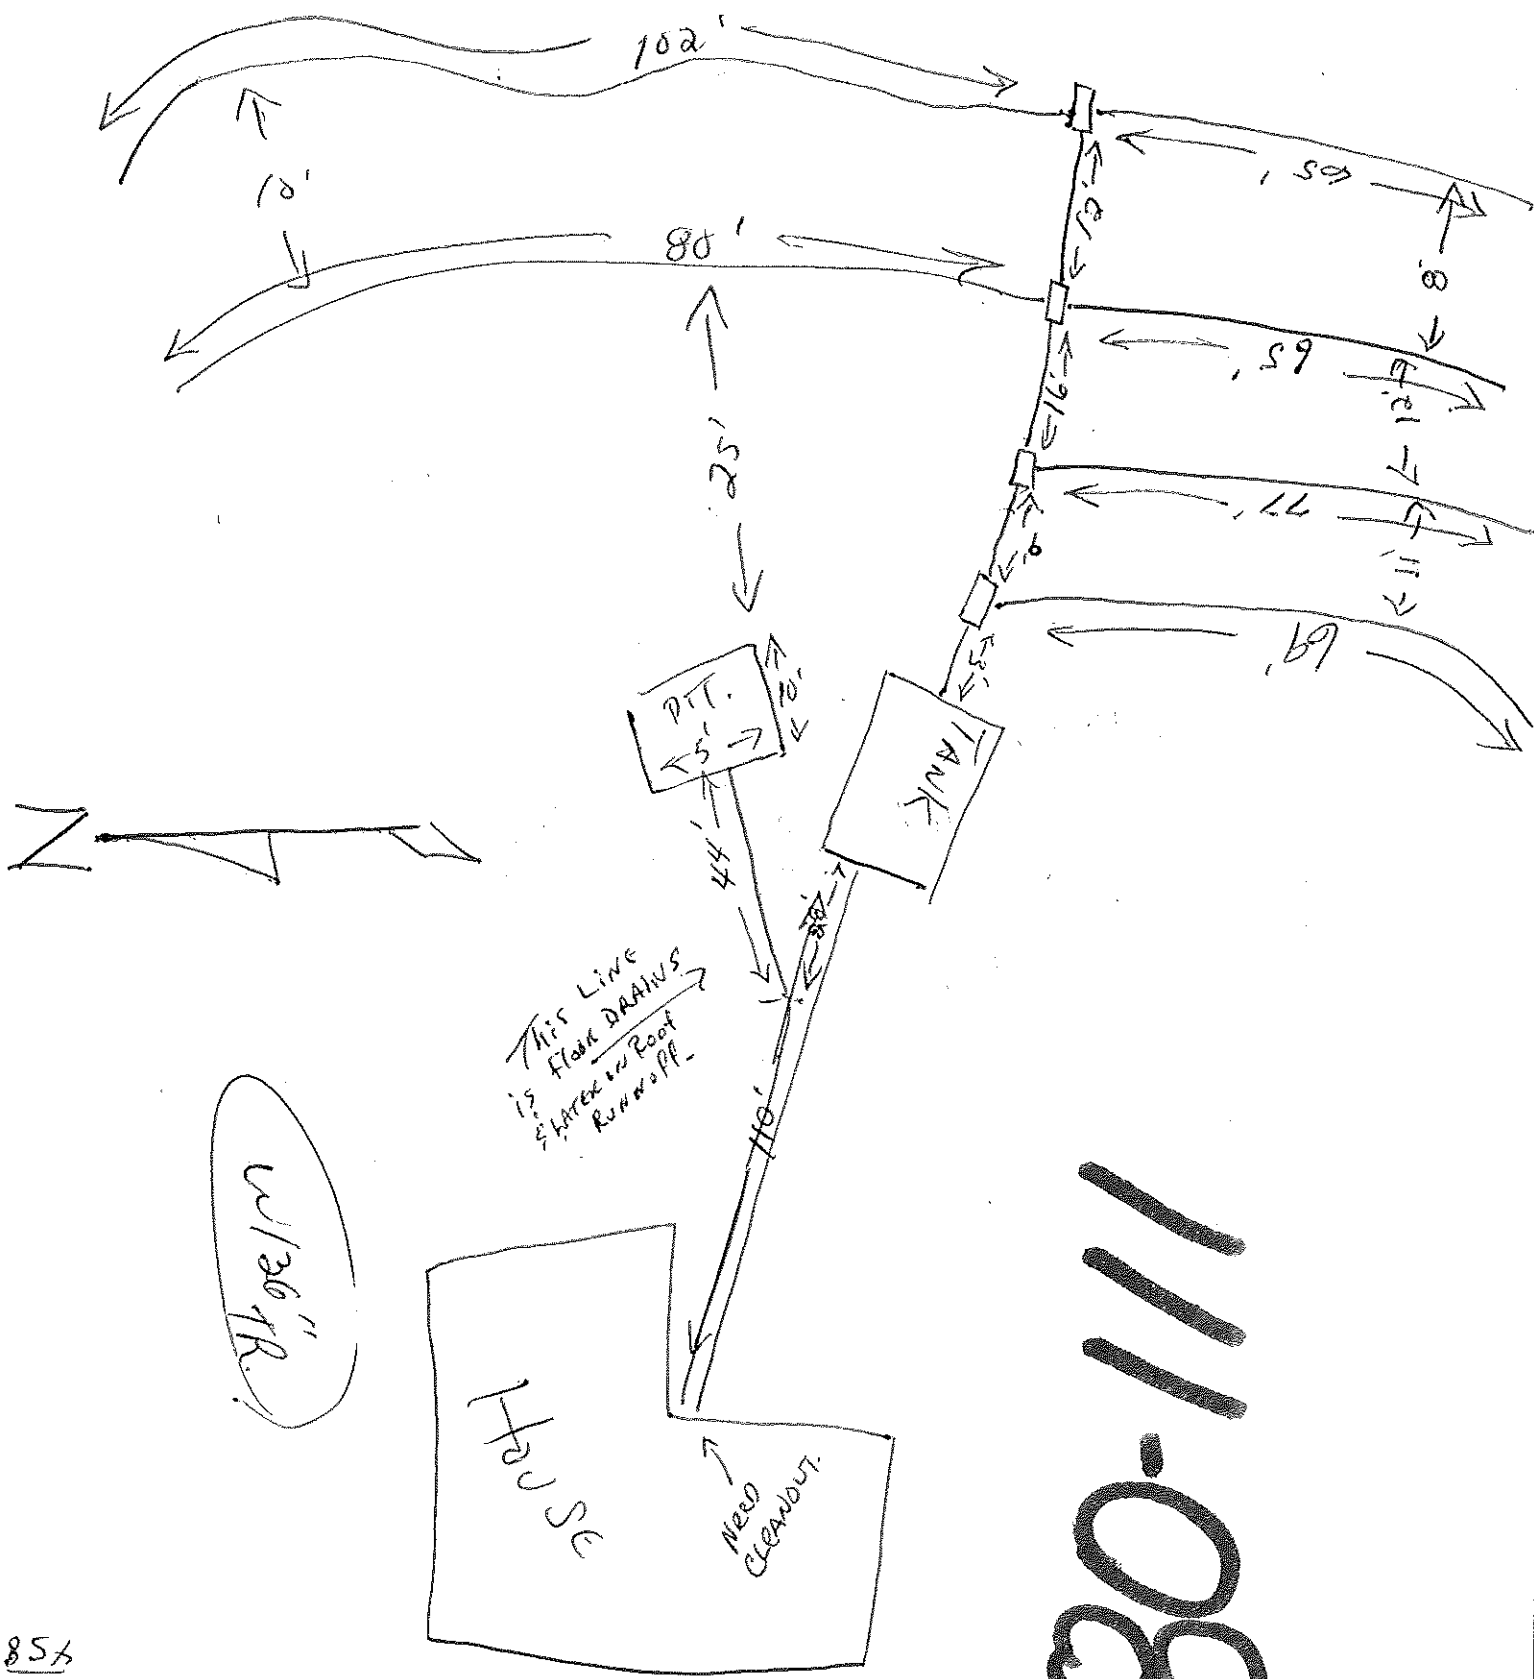

W/36" RR.

80-111

85X
 2016
 08
 59
 50
 77
 69