

96226

DATE May 22, 1996

Code \_\_\_\_\_ LOCATION Jackson Twp, Township

(circle one)		
<input checked="" type="checkbox"/> Existing Home	<input type="checkbox"/> New Home	<input type="checkbox"/> Mobile Home
<input type="checkbox"/> City Water	<input type="checkbox"/> Cistern	<input type="checkbox"/> Well
<input type="checkbox"/> Subdivision	<input checked="" type="checkbox"/> Lot	
Basement w/plumbing fixtures Yes No		

very limited Area

part of SW 1/4; Sec. 23; T. 2 S; R. 3 E

HARRISON COUNTY HEALTH DEPT.  
245 Atwood St. N. Wing  
Corydon, Indiana 47112

APPLICATION FOR SITE SURVEY AND SEWAGE DISPOSAL PERMIT

Directions To Property Town of Ramsey - S. side of SR 64 Between  
And Lot Size: Est R lounge + van wheels Auto (C) SW of the Int.  
of SR 64, + Corydon - Ramsey Rd

OWNER'S NAME AND MAILING ADDRESS  
Wayne Batman  
1575 Hwy 64 NW / Ramsey 47166

INSTALLERS'S NAME AND ADDRESS  
Jerome "gogi" Davis

TELEPHONE 347-2227

TELEPHONE 738-2374

NO. OF BEDROOMS 2 NO. OF BATHS 1 AUTOMATIC WASHER YES  NO

Booster Blending \* HOME MUST BE STAKED OFF BEFORE SURVEY IS CONDUCTED  
into \* DO NOT WRITE BELOW THIS LINE \*

SOIL TYPE: Argonidlike by position + garden soil exposed

Estimated Depth To Bedrock or Water Table: \_\_\_\_\_

SPECIAL Recommendations: Set new 100.0 gal tank as high on slope as possible /  
manifold out to box 2 to 1, 1 to 1 / shoot gunders. follow bottom /  
Flag water line - inspect at junction

SEPTIC TANK CAPACITY 1000 gal DRAINFIELD: TRENCH DEPTH 36" max TRENCH WIDTH 36" max

TOTAL LENGTH OF TILELINE 166 linear ft USING RIVER GRAVEL (No Crushed Stone) 12'

APPLICATION FOR PERMIT APPROVED  NOT APPROVED \_\_\_\_\_

DATE: May 22, 1996 Fee Received: pd SANITARIAN Jay A. Florence

FINAL INSPECTION: Approved 10-4-1996 DATE: Jay A. Florence  
Sanitarian

NOTE: 1000 cash

THE SEWAGE DISPOSAL PERMIT MUST BE APPROVED BEFORE CONSTRUCTION IS STARTED  
INSPECTION MUST BE MADE BEFORE THE LATERAL LINES ARE COVERED.  
Call for inspection either the day before or between 8:00 and 9:00 in mornings, 738-3237.  
The maximum length of any one trench is 100 feet.  
Six (6) inches of gravel under lateral lines and two (2) inches above pipe.  
Must be installed 50 feet or more from water supply lines.  
Five (5) feet or more from property lines.  
Distances between trenches — seven one-half (7 1/2) feet.  
On the back draw a plot diagram showing the size and shape of the lot, location of utility buildings,  
wells, roads, and/or streams within 100 feet of the disposal system, the location of the septic tank,  
and the location of the drainage field. Approximate distances must be shown from the disposal system  
to any proposed or existing water lines, wells, streams, and the lot lines.

If construction is not started within a period of one year, this permit is void.


WARNING: THIS PERMIT IN NO WAY GUARANTEES THE OPERATION OF THIS PRIVATE  
SEWAGE DISPOSAL SYSTEM. IT ONLY AFFIRMS THAT THE SYSTEM WAS INSTALLED TO  
PRESCRIBED STANDARDS.

922-96

N  
A

MATERIALS:

- Sch. 35 ( ASTM 3034 ) solid pipe
- Sch. 30 ( ASTM 2729 ) poly pipe with primer gravel
- heavy grade 4" barrier material over 12" of S-L" river gravel.

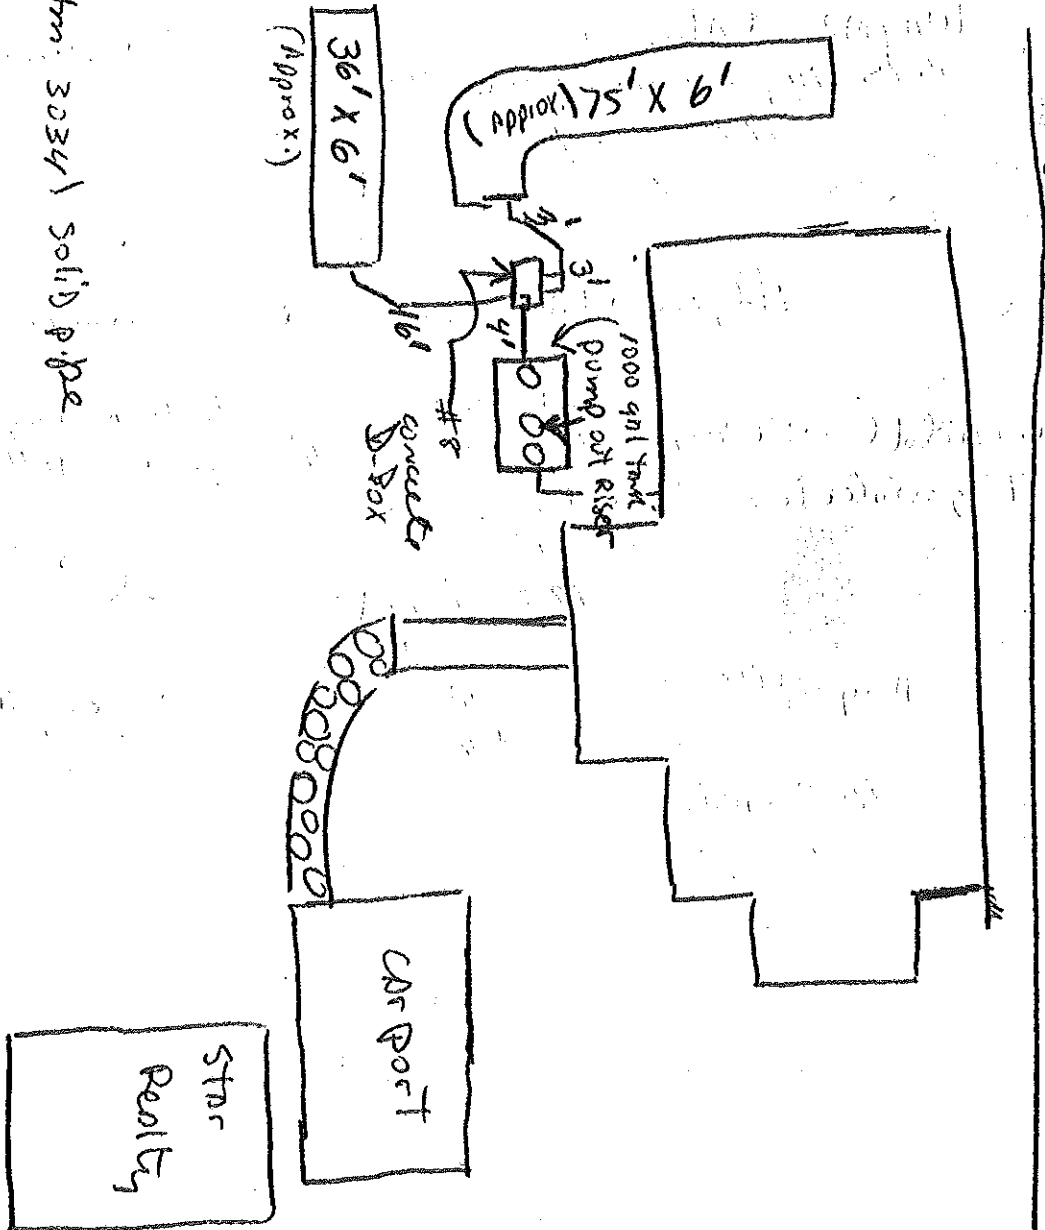

Corydon Ramsey Inc